


Basic Detail Report

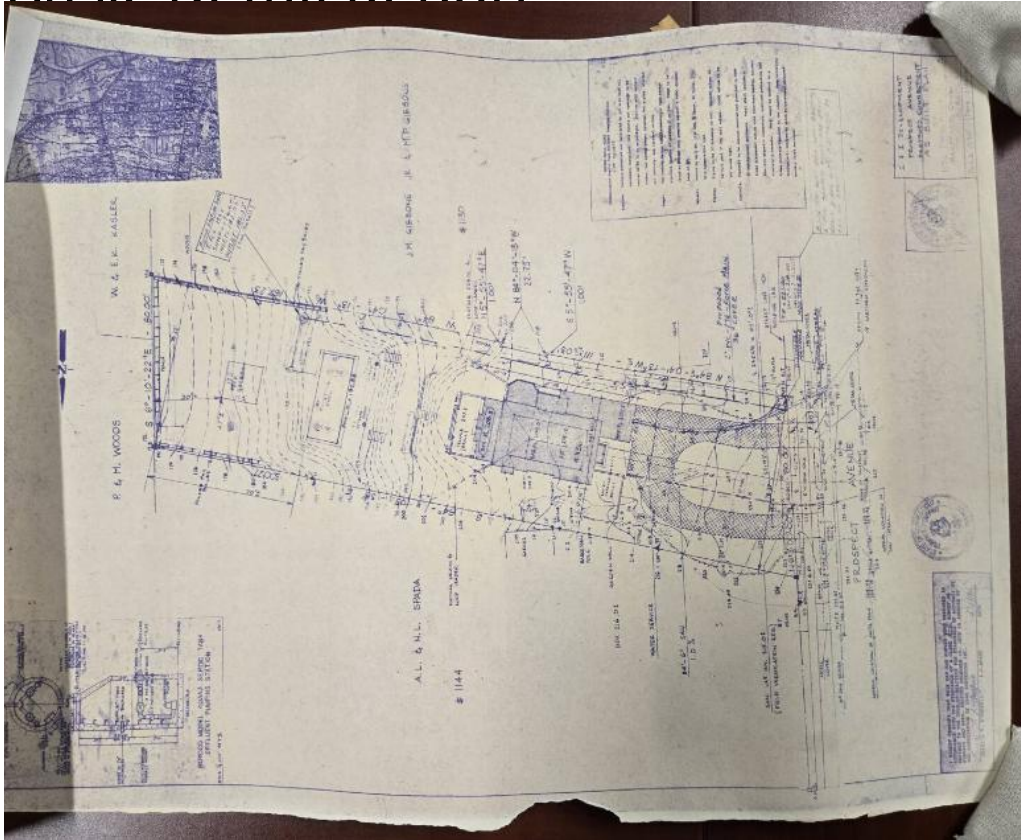

Title As Built Plan, 1136 Prospect Avenue, Hartford

Date 1988

Medium Copy of architectural drawing; black ink on paper

Description Copy of an architectural drawing of the as built plans for 1136

Prospect Avenue in Hartford.

Dimensions Primary Dimensions (height x width): 23 × 17in. (58.4 × 43.2cm)

Sheet (height x width): 24 × 18in. (61 × 45.7cm)